


CONNETTORE TIPO B (CON MOLLA DI RITEGNO INTERNA)
CONNECTOR TYPE B (WITH INTERNAL SPRING)

SCALA NON IMPEGNATIVA (DO NOT SCALE) | DIMENSIONI IN (DIMENSIONS IN) mm | METRIC | PROIEZIONE EUROPEA (EUROPEAN PROJECTION)

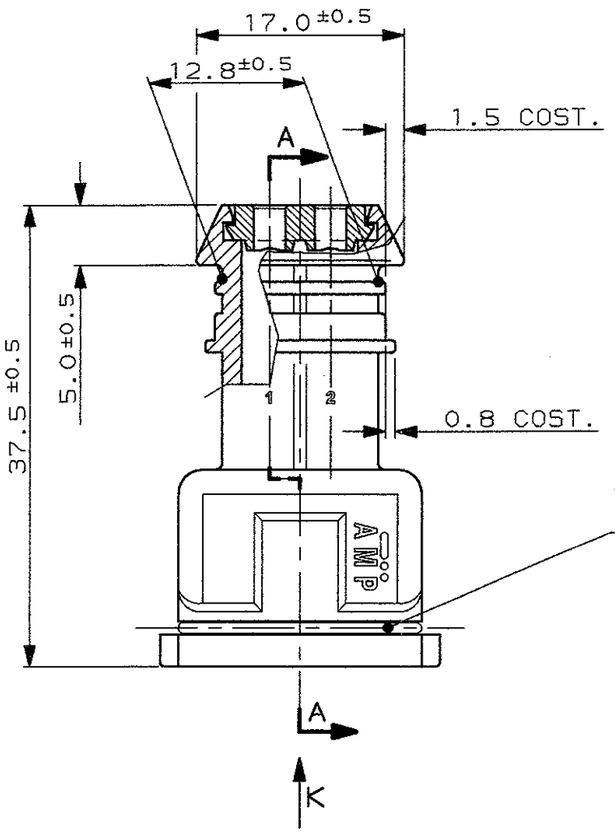

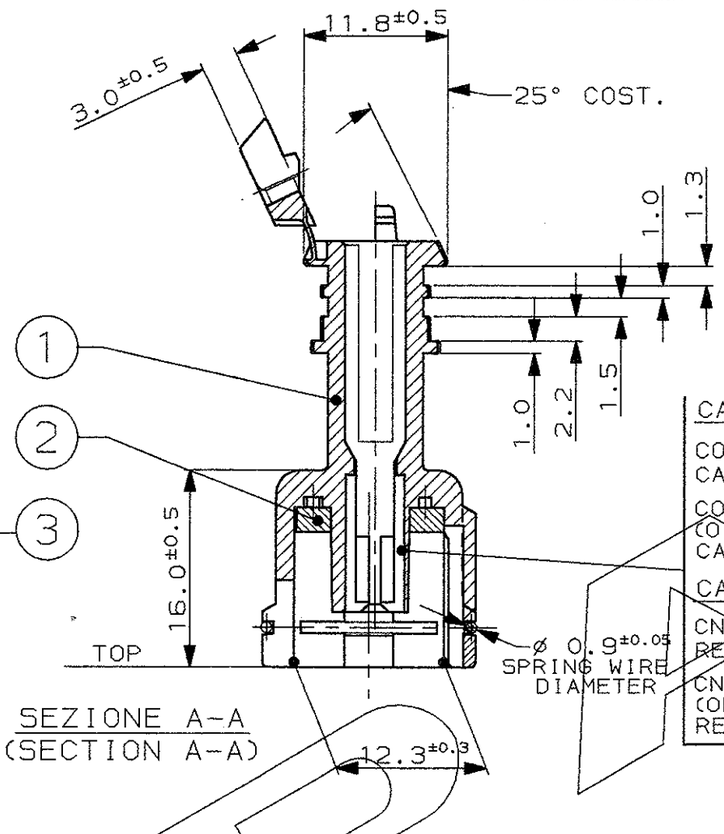

SEZIONE A-A
(SECTION A-A)

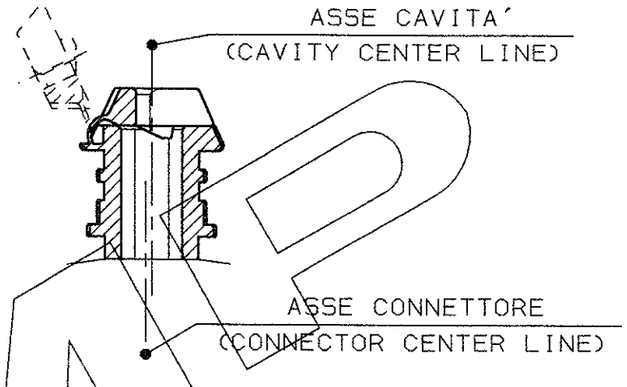

CAVITA' ADATTA PER TERMINALI JUNIOR POWER TIMER:

CONTATTO P/N 929939-1 O -3 CON GOMMINO P/N 828904-1
CAVO ISOLANTE RIDOTTO ø1.5-2.1mm; SEZIONE 0.5-1.0mm²


CONTATTO P/N 929937-1 O -3 CON GOMMINO P/N 828905-1
(O GOMMINO P/N 282536-1 SOLO PER CAVI SEZIONE 2.5mm²)
CAVO ISOLANTE RIDOTTO ø2.2-3.0mm; SEZIONE 1.5-2.5mm²

CAVITY SUITABLE FOR JUNIOR POWER TIMER CONTACT:

CNT. P/N 929939-1 OR -3 PLUS WIRE SEAL P/N 828904-1
REDUCED INS. CABLE ø1.5-2.1mm; WIRE RANGE 0.5-1.0mm²

CNT. P/N 929937-1 OR -3 PLUS WIRE SEAL P/N 828905-1
(OR WIRE SEAL P/N 282536-1 ONLY FOR WIRE SECT. 2.5 mm²)
REDUCED INS. CABLE ø2.2-3.0mm; WIRE RANGE 1.5-2.5mm²

- PER DIMENSIONI CONTROPARTE VEDERE FOGLIO 2 DI 2.
(- FOR PIN HEADER DIMENSIONS SEE SHEET 2 OF 2).

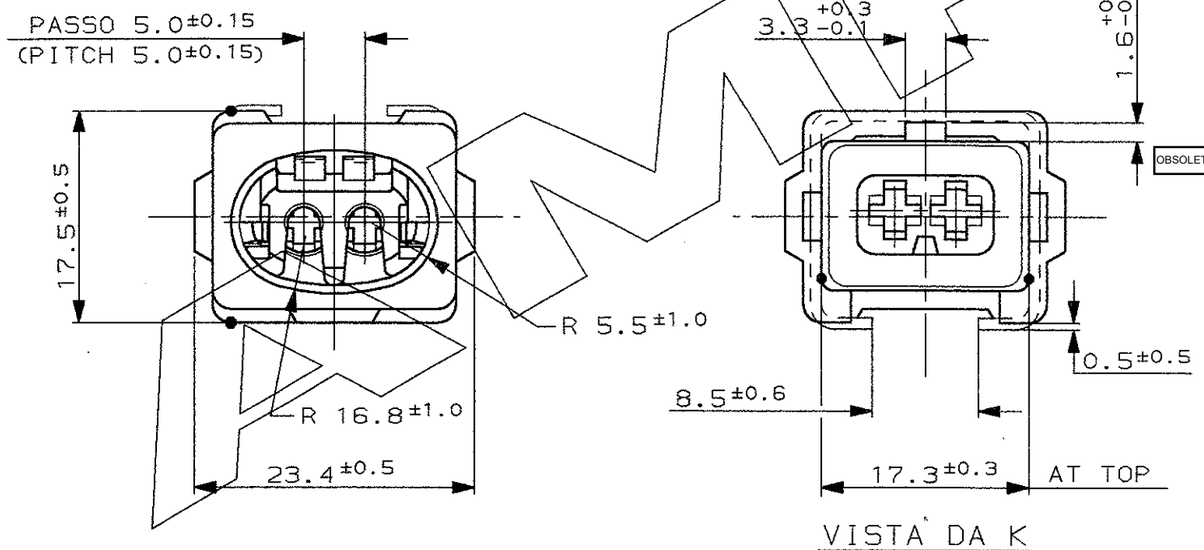

VISTA DA K
(VIEW FROM K)

ROSSO (RED)	282788-8
GIALLO (YELLOW)	282788-7
MARRONE (BROWN)	282788-6
BLU (BLUE)	282788-5
VERDE (GREEN)	~~282788-4~~ OBSOLETE
NATURALE (NATUR)	282788-3
GRIGIO (GREY)	282788-2
NERO (BLACK)	282788-1
COLORE (COLOR)	NUMERO (PART N°.)

N° (ITEM)	FINITURA / COLORE (FINISH / COLOUR)	MATERIALE (MATERIAL)	DESCRIZIONE (DESCRIPTION)
3	\\\\\\\	ACCIAIO INOX (STAINLESS STEEL)	MOLLA (SPRING)
2	NATURALE (NATURAL)	GOMMA (RUBBER)	GUARNIZIONE (RUBBER GASKET)
1	\\\\\\\	PA 6.6	BLOCCHETTO (HOUSING)

REV.	REVISIONI (REVISION RECORD)	DIS. (DR)	DATA (DATE)
C1	REVISED PER ECO-20-003218	AP/VN	08MAY 2020
C	ECR-14-003472	MP	24MAR 2014
B	IN PRODUZIONE (RELEASED FOR PRODUCTION) EC ET00-0325-96	A.F.	26 JUL '96
A1	REVISED PER EC ET00-0096	A.F.	26 FEB '96
A	FIRST ISSUE PER EC ET00-0004-96 (PROP. NO. WAS 95-51276)	R.M.	03-01 '96

CUSTOMER DWG. FOR REFERENCE ONLY | DISEGNO PER CLIENTE SOLO PER RIFERIMENTO

~~THIS DRAWING IS UNPUBLISHED~~ | RELEASE FOR PUBLICATION 19

© COPYRIGHT 19 BY AMP INCORPORATED, HARRISBURG, PA. ALL INTERNATIONAL RIGHT RESERVED. AMP PRODUCTS MAY BE COVERED BY U.S. AND FOREIGN PATENT AND/OR PATENT PENDING

TOLLERANZE, SE NON DIVERSAMENTE SPECIFICATO (TOLERANCES, UNLESS OTHERWISE SPECIFIED): ± 0.3
ANGOLI (ANGLES): ± 2°

DIAM. ISOLANTE (INS. DIA. RANGE): 1.5-3.0 (REDUCED INS. CABLE)
RANGO FILO (WIRE RANGE): 0.5-2.5 mm²
SCALA (SCALE): ***

TE Connectivity

DESCRIZIONE (DESCRIPTION): 2 POS. SPLASH PROOF CONN. ASS'Y with SECONDARY LOCK


DIS. (DR.) 22 DEC 95 R. MARTINI
CONT. (CHK) 22 DEC 95 C. TARTARI
APP. (APP.)


LOC. I | SIZE A3 | NUMERO (DWG NO) C-282788 | REV. C1 | FOGLIO (SHEET) 1 DI (OF) 2

DISTRIBUZIONE (PRINT DIST.)


AMP-ITA 7529 - 5/02

SCALA NON IMPEGNATIVA (DO NOT SCALE)
DIMENSIONI IN (DIMENSIONS IN) mm
METRIC
PROIEZIONE EUROPEA (EUROPEAN PROJECTION)

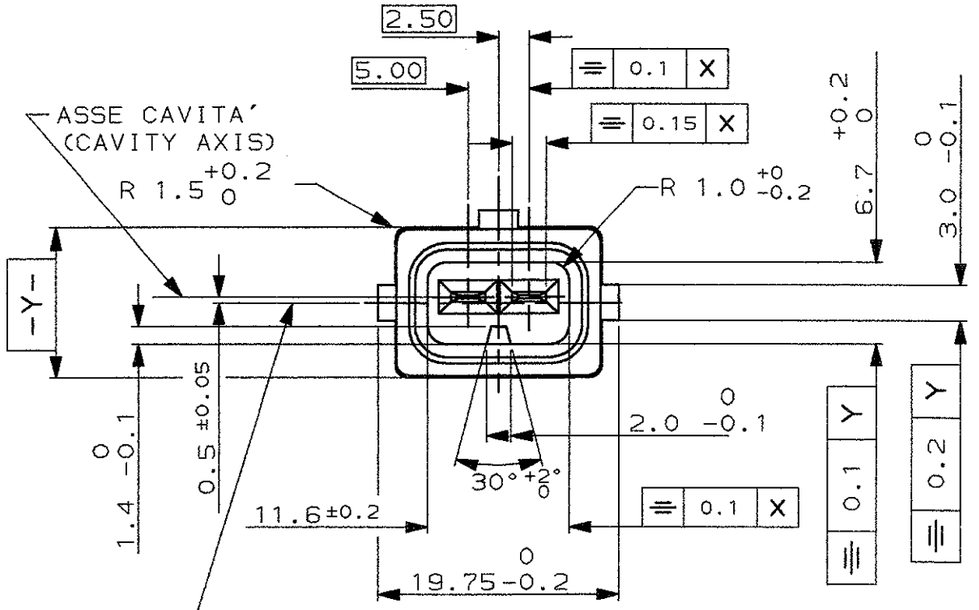


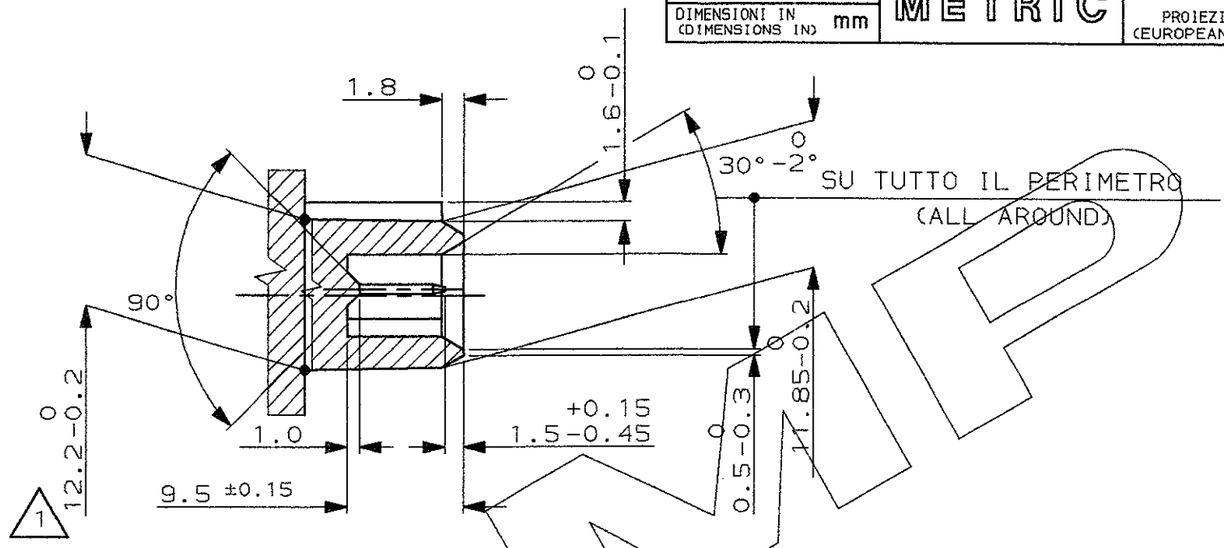

DETT. CONTATTO SC. 5:1
(TAB DETAIL SC. 5:1)

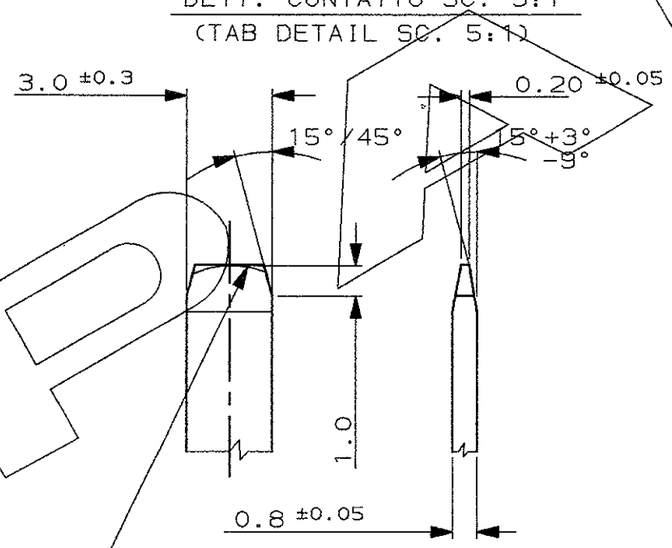

FORMA ALTERNATIVA PERMESSA CON RAGGIO
(ALLOWED ALTERNATIVE PROFILE WITH RADIUS)

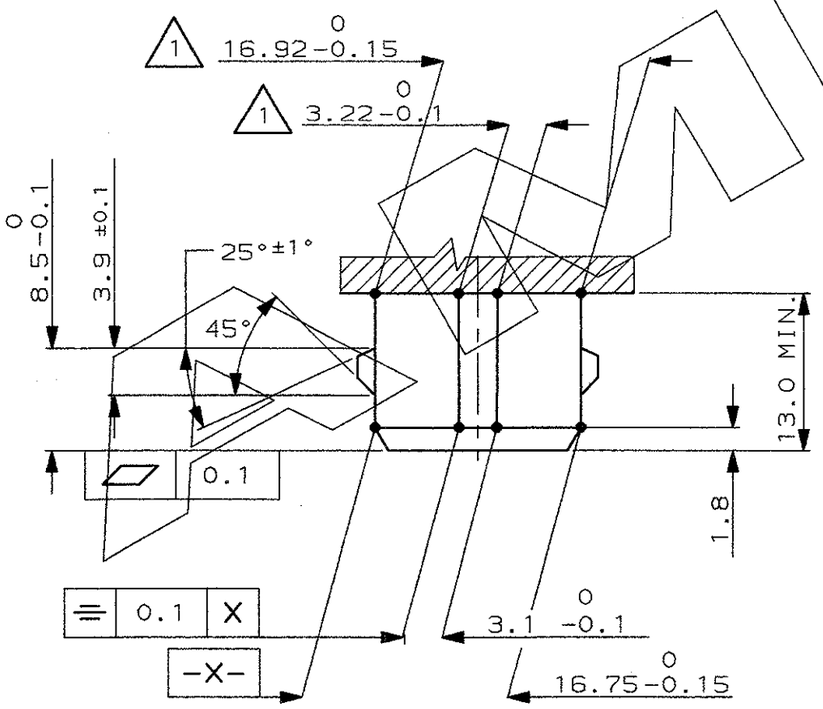

NOTE (NOTES):

1 QUOTE APPLICABILI PER SFORMATURA PEZZO
(RIGHT DIMENSIONS FOR EXTRACTION ITEM FROM THE MOULD)

2) MATERIALE CONTATTI: LEGA DI RAME STAGNATA, ES. OTTONE STAGNATO.
(TAB MATERIAL: TINNED Cu ALLOY, E.G. TINNED BRASS)

3) MATERIALE BLOCCHETTO: TERMOPLASTICO CARICATO FIBRA VETRO.
(HOUSING MATERIAL: THERMOPLASTIC GLASS FIBER FILLED).

AMP

REV.	REVISIONI (REVISION RECORD)	DIS. (DR)	DATA (DATE)	APP. (APP.)
	SEE SHEET 1 OF 2			

FINITURA / COLORE (FINISH / COLOUR)	MATERIALE (MATERIAL)	NUMERO (PART NUMBER)
CUSTOMER DWG. FOR REFERENCE ONLY	DISEGNO PER CLIENTE SOLO PER RIFERIMENTO	

THIS DRAWING IS UNPUBLISHED | RELEASE FOR PUBLICATION 19

© COPYRIGHT 19 BY AMP INCORPORATED, HARRISBURG,PA. ALL INTERNATIONAL RIGHT RESERVED. AMP PRODUCTS MAY BE COVERED BY U.S. AND FOREIGN PATENT AND/OR PATENT PENDING

TOLLERANZE, SE NON DIVERSAMENTE SPECIFICATO (TOLERANCES, UNLESS OTHERWISE SPECIFIED)	DIAM. ISOLANTE (INS. DIA. RANGE)	RANGO FILO (WIRE RANGE)	SCALA (SCALE)
± 0.3	SEE SHEET 1	SEE SHEET 1	***
ANGOLI (ANGLES) ± 2°			

TE Connectivity

DIS. (DR.)	DESCRIZIONE (DESCRIPTION)
SEE SHEET 1 OF 2	2 POS. SPLASH PROOF CONN. ASS'Y with SECONDARY LOCK
CONT. (CHK)	
APP. (APP.)	

LOC.	SIZE	NUMERO (DWG NO)	REV.	FOGLIO (SHEET)
I	A3	C-282788	C1	2 DI (OF) 2

DISTRIBUZIONE (PRINT DIST.)

AMP-ITA 7523 - 5/82